



20160021

FILTER BODY

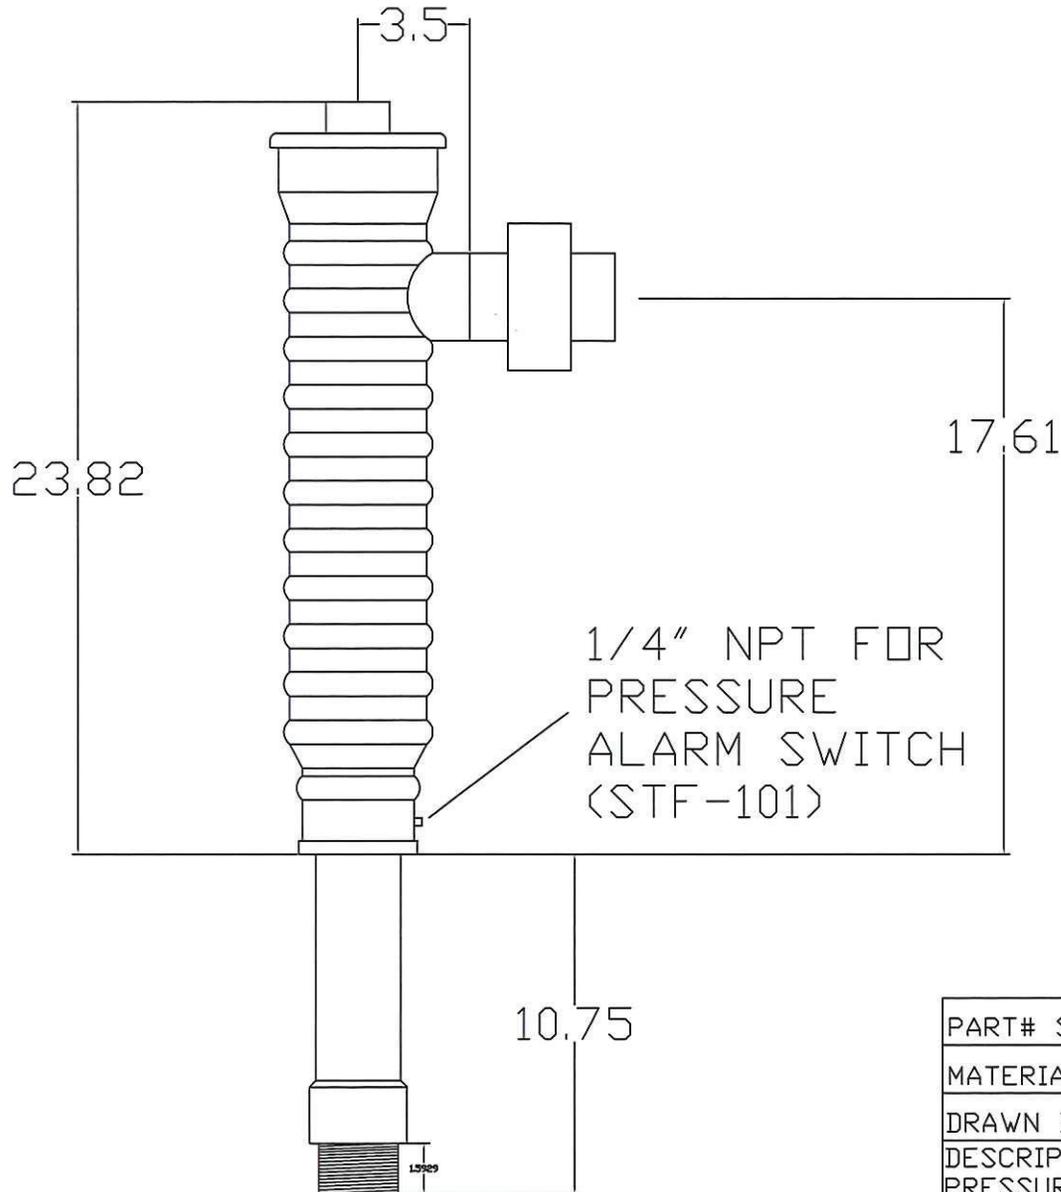


FILTER SCREEN:  
PERFORATED METAL  
22 GA. STAINLESS STEEL  
TYPE ~~347~~ WITH 0.062  
HOLES <sup>3/16L</sup>

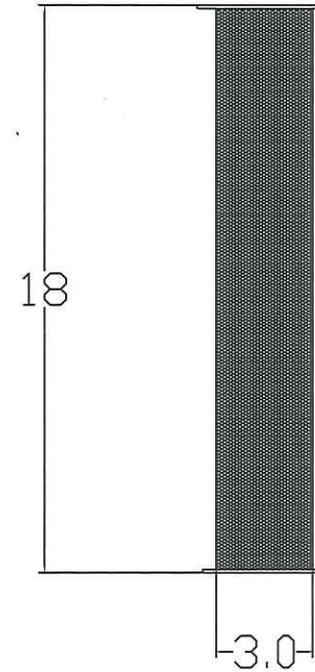


PART# STF-100	DATE: 09/22/06
MATERIAL:	REV: A
DRAWN BY: JASON MAY	APPROVED BY:
DESCRIPTION: JOB READY PRESSURE FILTER	

20160021

FILTER BODY

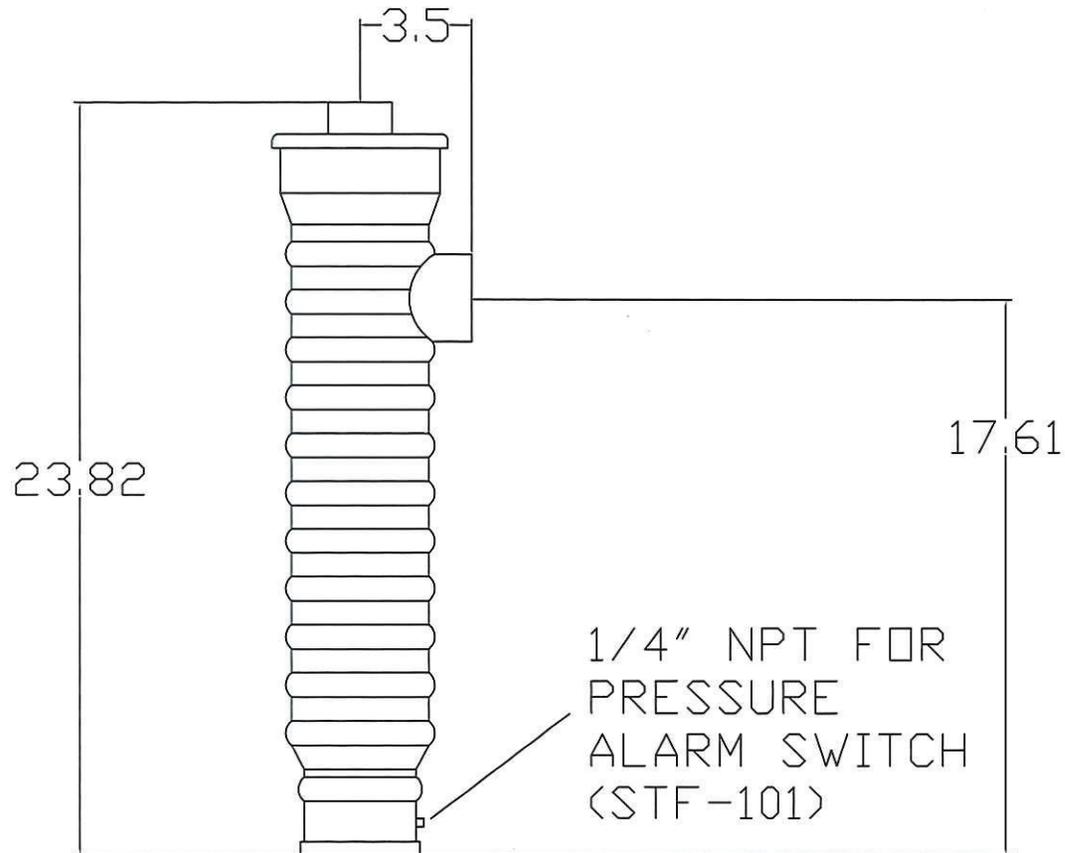


FILTER SCREEN:  
PERFORATED METAL  
22 GA. STAINLESS STEEL  
TYPE ~~304~~ WITH 0.062  
HOLES <sup>316L</sup>

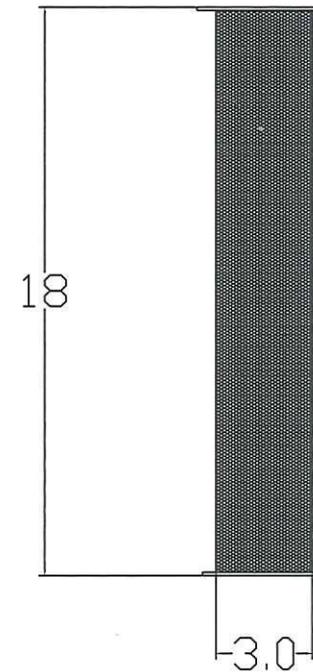


PART# STF-100A2	DATE: 09/22/06
MATERIAL:	REV: A
DRAWN BY: JASON MAY	APPROVED BY:
DESCRIPTION: FIELD ASSEMBLE PRESSURE FILTER	

20160021

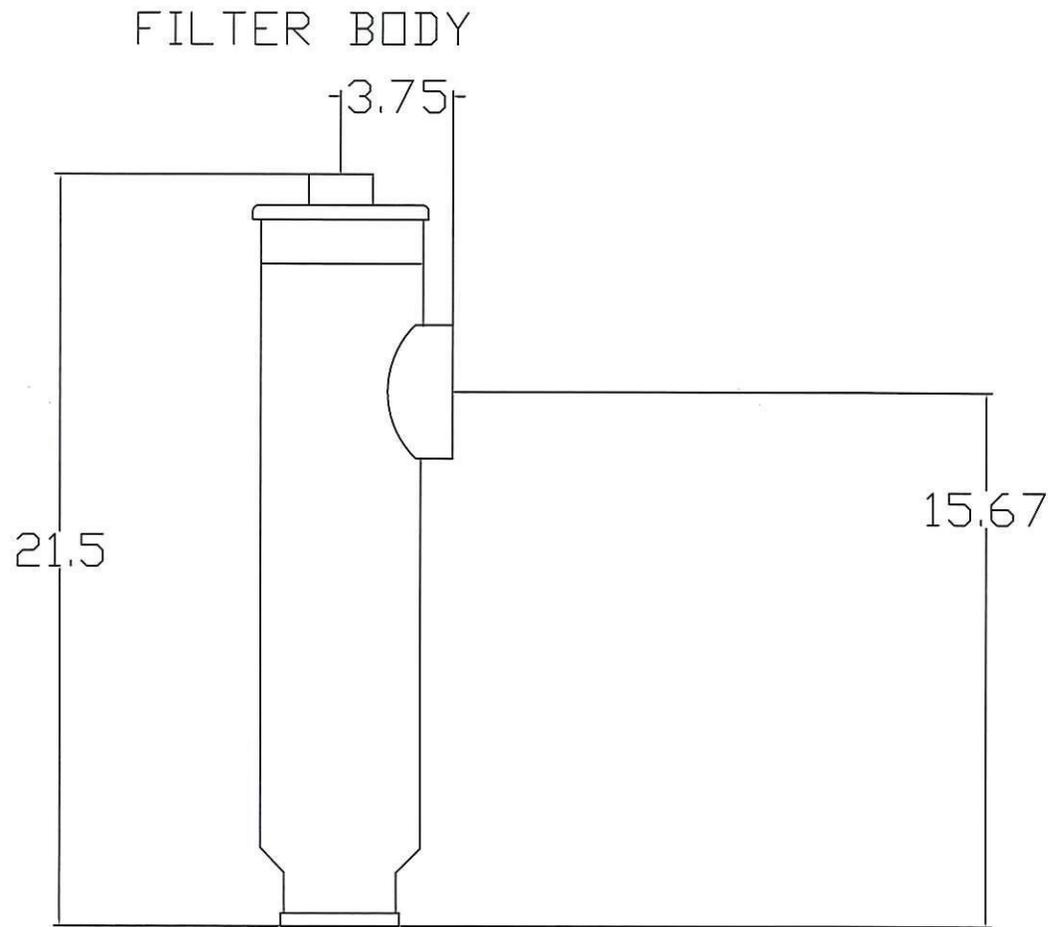

FILTER SCREEN:  
PERFORATED METAL  
22 GA. STAINLESS STEEL  
TYPE ~~304~~ WITH 0.062  
HOLES <sup>316L</sup>

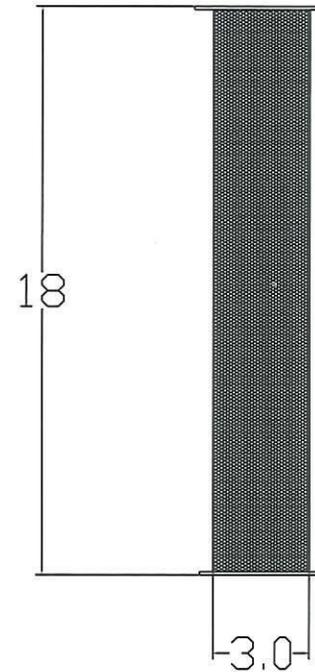

NOT TO SCALE

PART# STF-100A3	DATE: 09/22/06
MATERIAL:	REV: A
DRAWN BY: JASON MAY	APPROVED BY:
DESCRIPTION: FIELD ASSEMBLE PRESSURE FILTER	