~~20110264A~~
20160129

Water Volume Chart

Model: 500 Gallon Pump Tank

Product File Number: 20110264

Height (inches)	Volume (gallons)	Height (inches)	Volume (gallons)	Height (inches)	Volume (gallons)
66	579	**44**	374	**22**	170
65	570	**43**	365	**21**	161
64	560	**42**	356	**20**	151
63	551	**41**	347	**19**	142
62	542	**40**	337	**18**	133
61	533	**39**	328	**17**	123
60	523	**38**	319	**16**	114
59	514	**37**	309	**15**	105
58	505	**36**	300	**14**	96
57	495	**35**	291	**13**	86
56	486	**34**	282	**12**	77
55	477	**33**	272	**11**	69
54	467	**32**	263	**10**	61
53	458	**31**	254	**9**	54
52	449	**30**	244	**8**	46
51	440	**29**	235	**7**	39
50	430	**28**	226	**6**	32
49	421	**27**	216	**5**	25
48	412	**26**	207	**4**	18
47	402	**25**	198	**3**	14
46	393	**24**	189	**2**	9
45	384	**23**	179	**1**	5

PART/PRINT #:	PART DESCRIPTION:	DATE:
HA-180058-107	TANK, PUMP 500	9/7/11

20160129

~~20110264B~~

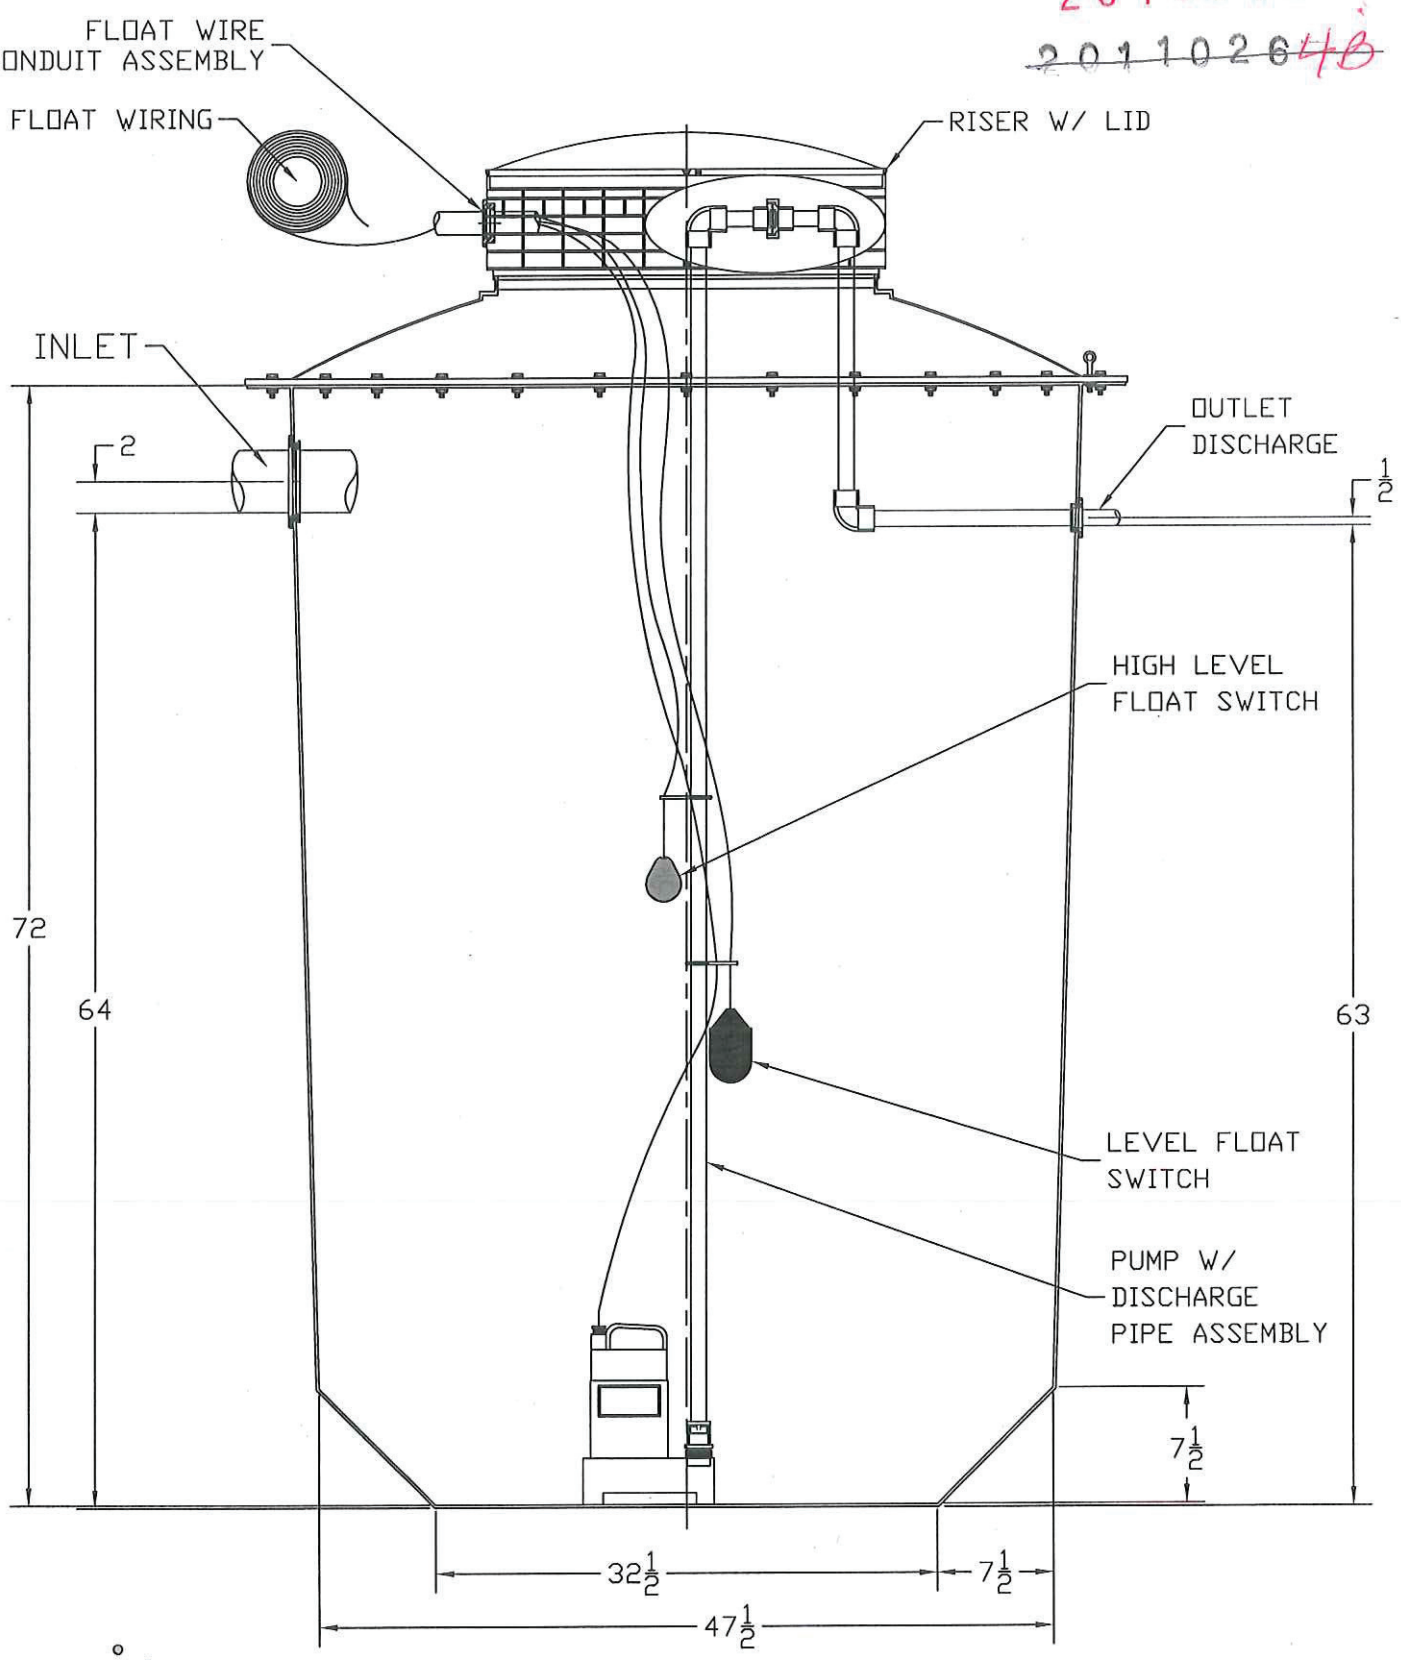

500 GALLON PUMP TANK

DRAWN BY:	SCALE:	REVISION#:	SIGNATURE:
A.DAVIS	1" = 1"		

hydroaction®
green from the ground up

THIS DRAWING IS THE SOLE PROPERTY OF AK/HA MANUFACTURING LLC