20160134

~~20110265~~ A

Water Volume Chart

Model: 750 Gallon Pump Tank

Product File Number: 20110265

Height (inches)	Volume (gallons)	Height (inches)	Volume (gallons)	Height (inches)	Volume (gallons)
66	776	**44**	494	**22**	212
65	763	**43**	481	**21**	199
64	750	**42**	468	**20**	187
63	738	**41**	456	**19**	174
62	725	**40**	443	**18**	161
61	712	**39**	430	**17**	148
60	699	**38**	417	**16**	135
59	686	**37**	404	**15**	122
58	673	**36**	392	**14**	110
57	661	**35**	379	**13**	97
56	648	**34**	366	**12**	84
55	635	**33**	353	**11**	75
54	622	**32**	340	**10**	65
53	609	**31**	327	**9**	56
52	597	**30**	315	**8**	46
51	584	**29**	302	**7**	38
50	571	**28**	289	**6**	31
49	558	**27**	276	**5**	24
48	545	**26**	263	**4**	16
47	533	**25**	251	**3**	12
46	520	**24**	238	**2**	8
45	507	**23**	225	**1**	4

PART/PRINT #:	PART DESCRIPTION:	DATE:
HA-180059-107	TANK, PUMP 750	9/7/11

20160134

~~20110265~~B

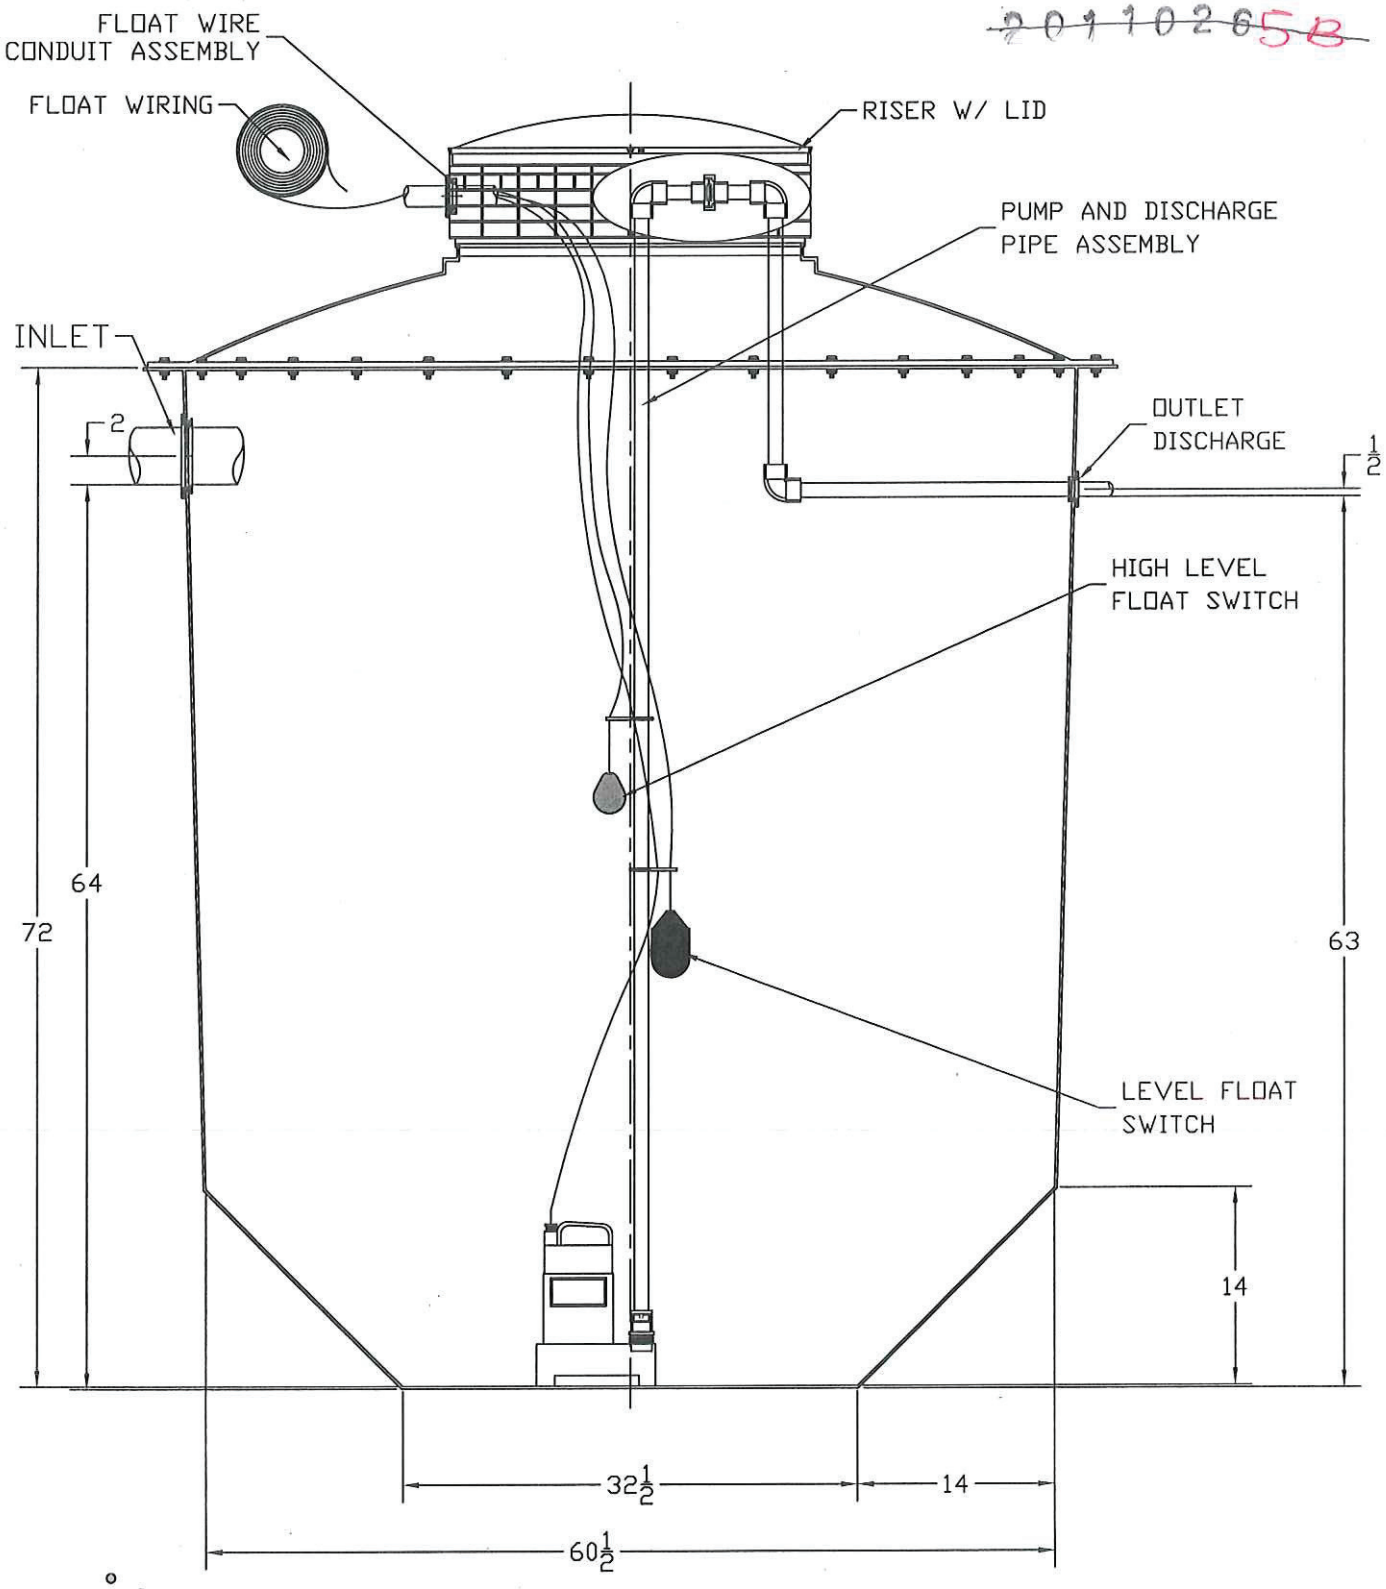

750 GALLON PUMP TANK

DRAWN BY:	SCALE:	REVISION#:	SIGNATURE:
A.DAVIS	1" = 1"		

THIS DRAWING IS THE SOLE PROPERTY OF AK/HA MANUFACTURING LLC