20160194 A

~~20130344 A~~

REVISION HISTORY				
ZONE	REV	DESCRIPTION	DATE	APPROVED

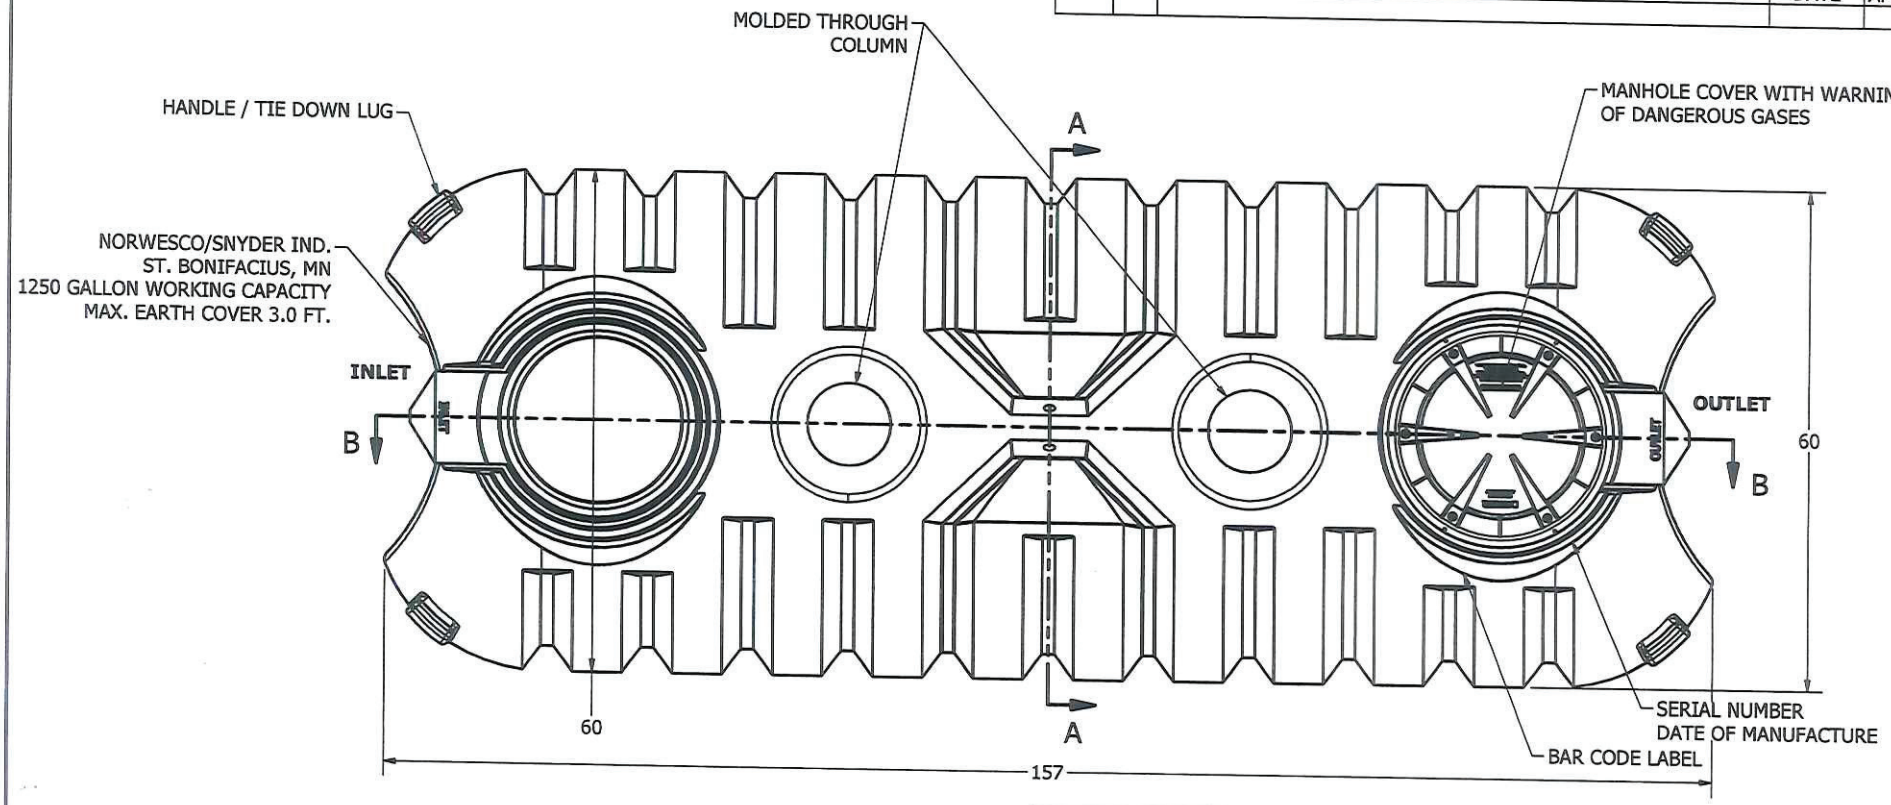

Conditionally
APPROVED

SEE CORRESPONDENCE

DRAWN	Todd Bolzer	5/27/2011
CHECKED		
QA		
MFG		
APPROVED		

NORWESCO
NORWESCO, INC., ST. BONIFACIUS, MN

TITLE
1250 GALLON LOW PROFILE HOLDING AND PUMP TANK WISCONSIN

SIZE	REV
B	

SCALE: 1/16

SHEET 1 OF 2

RECEIVED
OCT 21 2013
SAFETY & BUILDINGS

Conditionally APPROVED

20160194 A

~~20130344 A~~

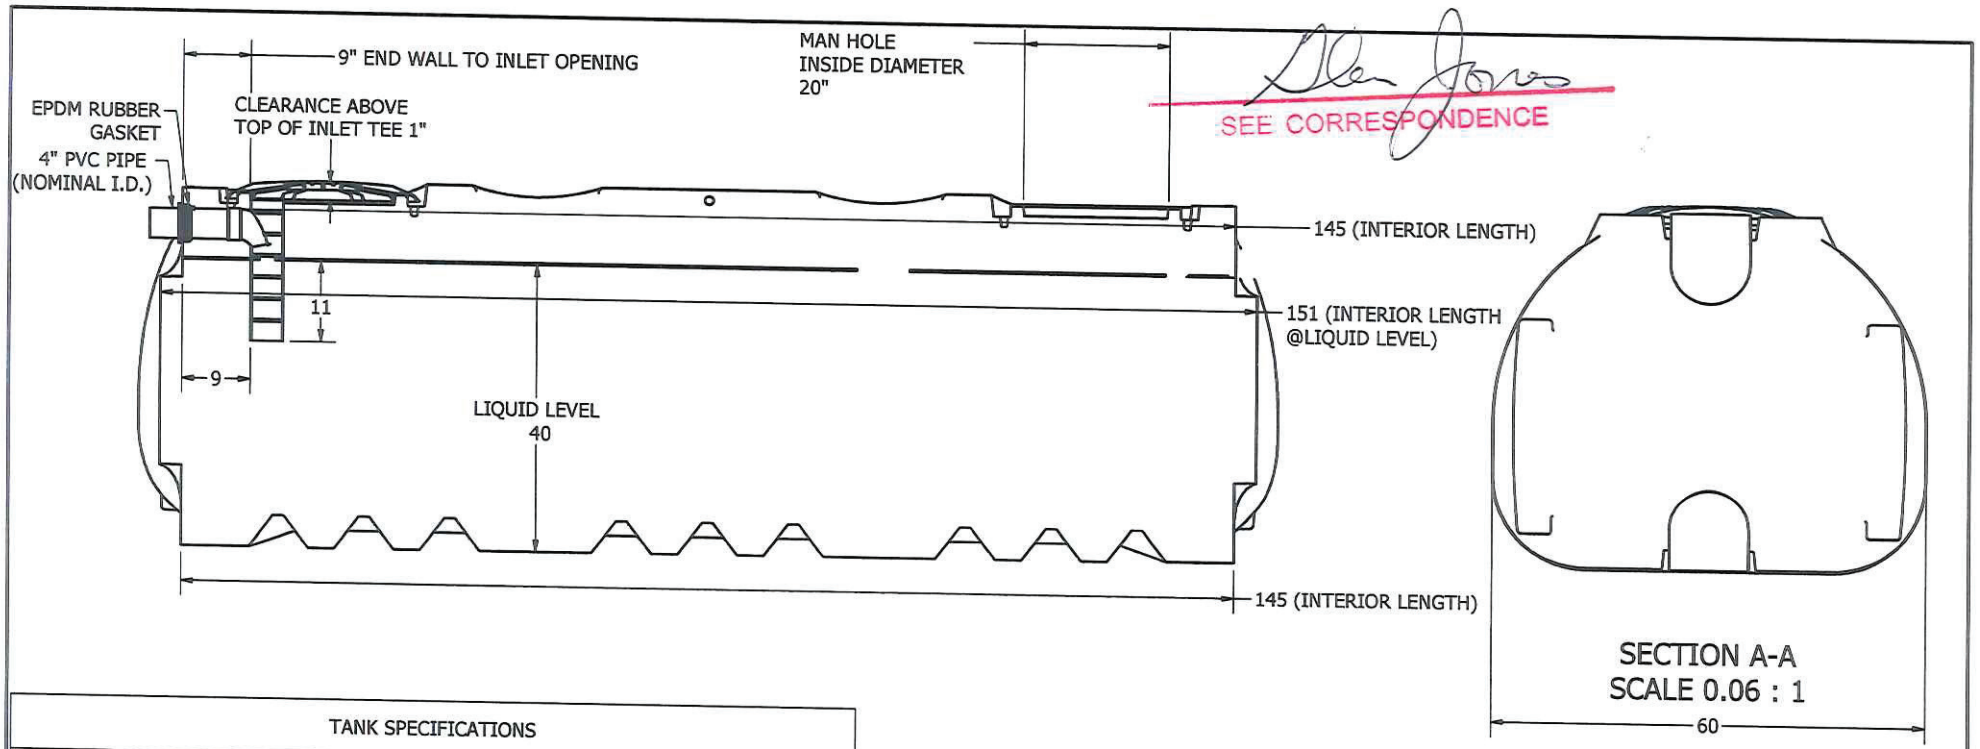

TANK SPECIFICATIONS	
INTERIOR LENGTH @ TOP	145 IN
INTERIOR LENGTH @ LIQUID LEVEL	151 IN
INTERIOR LENGTH @ BOTTOM	145 IN
INTERIOR WIDTH @ TOP	0 IN
INTERIOR WIDTH @ LIQUID LEVEL	50 IN
INTERIOR WIDTH @ BOTTOM	40 IN
HEIGHT (INTERIOR)	50.5 IN
LIQUID LEVEL	40 IN
WORKING CAPACITY	1250 GALLONS
FREEBOARD	15%
TANK TOP THICKNESS	.25 IN
TANK SIDE THICKNESS	.25 IN
TANK BOTTOM THICKNESS	.25 IN
TANK END THICKNESS	.25 IN

DRAWN Todd Bolzer	5/27/2011	NORWESCO, INC., ST. BONIFACIUS, MN
CHECKED		TITLE: 1250 GALLON LOW PROFILE HOLDING AND PUMP TANK WISCONSIN
QA		
MFG		
APPROVED		SIZE B; REV
		SCALE: 1/16; SHEET 2 OF 2

RECEIVED
OCT 21 2013
SAFETY & BUILDINGS

Conditionally
APPROVED

201-60194
20130344 A

SEE CORRESPONDENCE

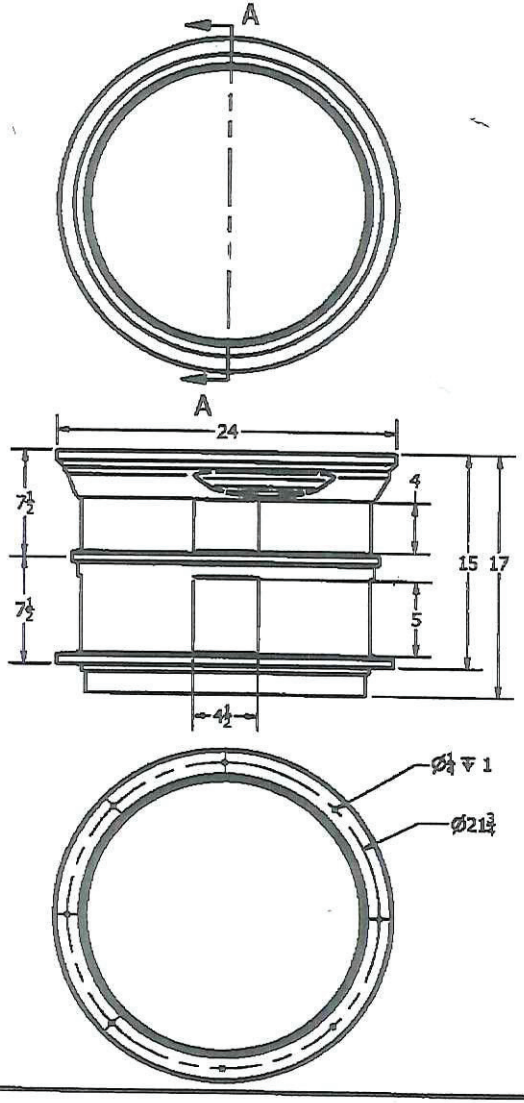

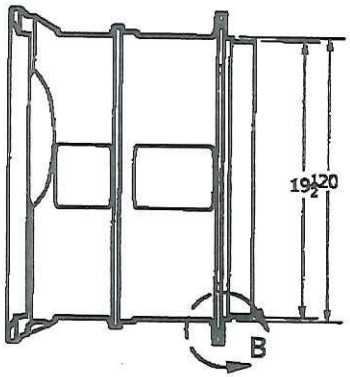

SECTION A-A
SCALE 1 /8

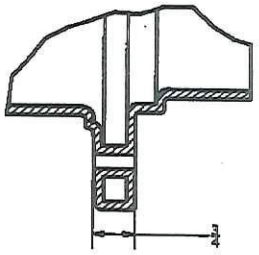

DETAIL B
SCALE 1 / 2

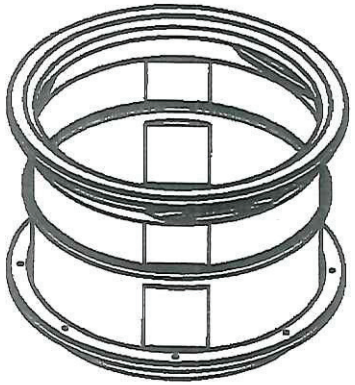

DRAWN Todd Bolzer	5/10/2009	NORWESCO, INC., ST. BONIFACIUS, MN
CHECKED		TITLE: 15 INCH LOW PROFILE MAN HOLE EXTENSION
QA		
MFG		
APPROVED		SIZE B; DWG NO; REV E
		SCALE: 1/16; SHEET 1 OF 1

RECEIVED
OCT 21 2013
SAFETY & BUILDINGS