20130320

~~20080189~~

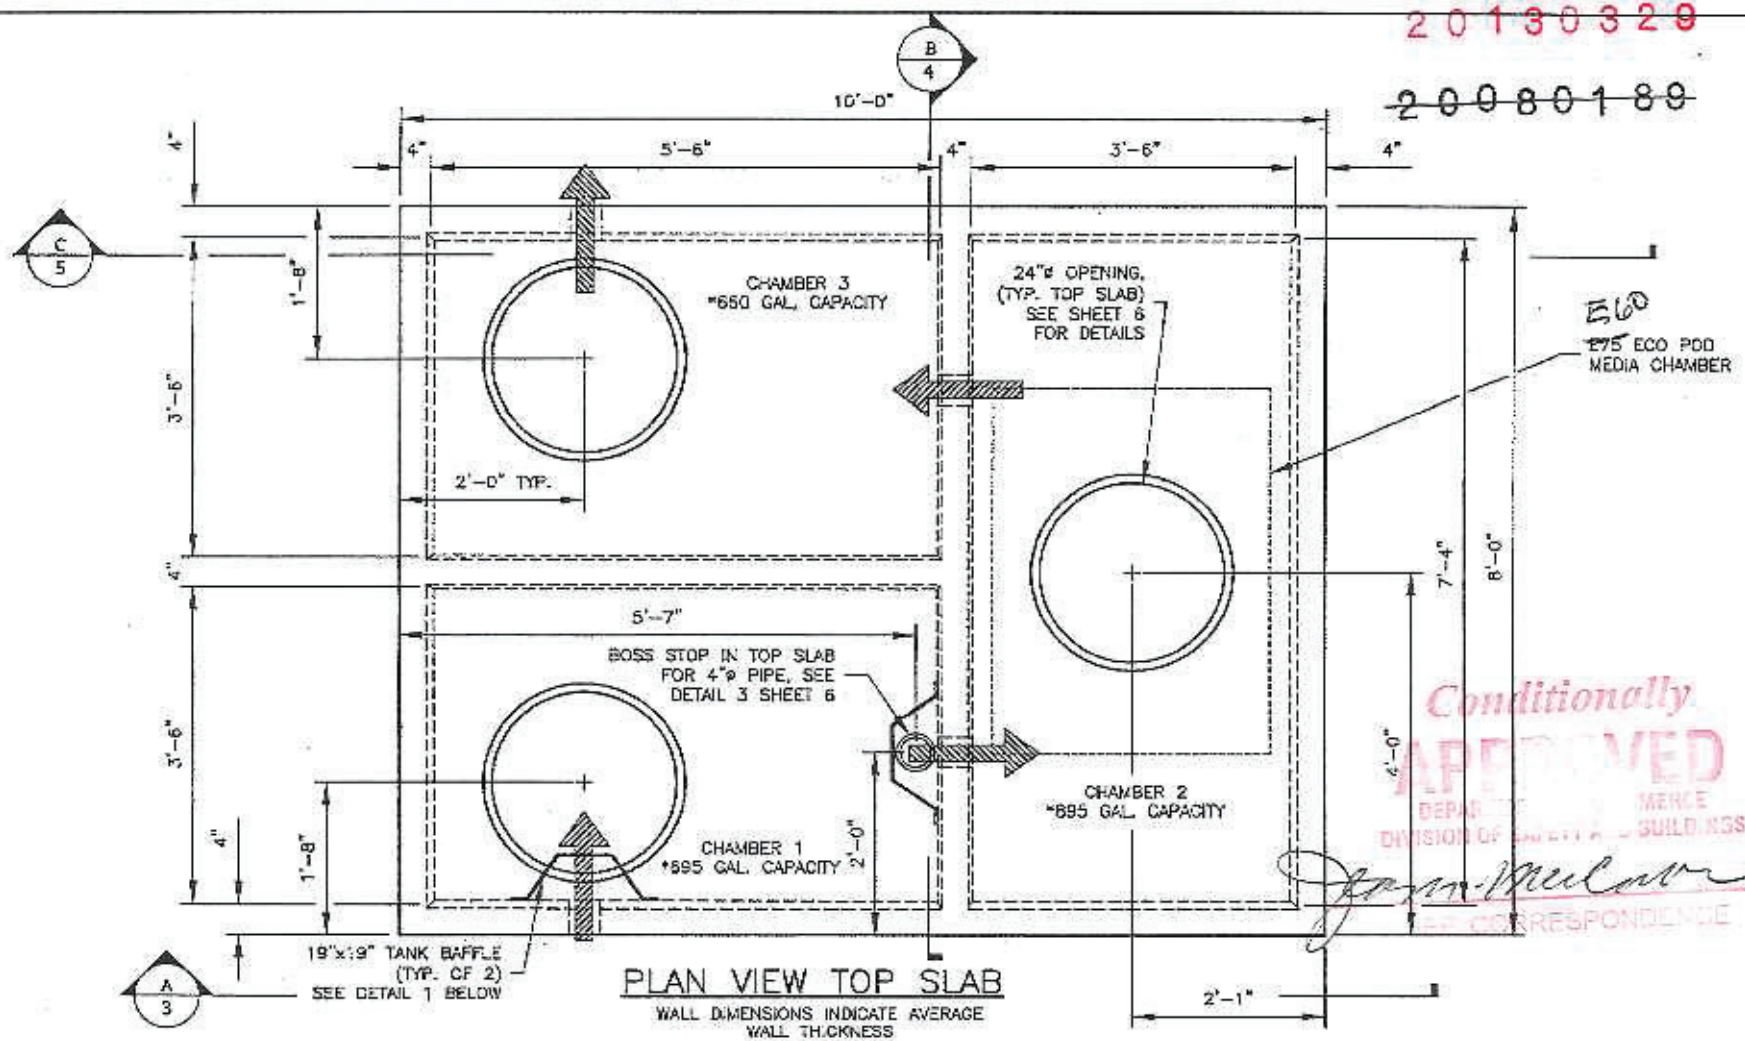

PLAN VIEW TOP SLAB

WALL DIMENSIONS INDICATE AVERAGE WALL THICKNESS

* CAPACITY IS BASED ON AN AVERAGE WALL THICKNESS OF 4"

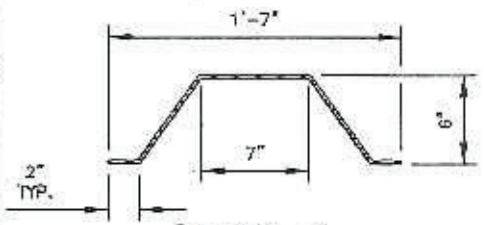

DETAIL 1

- TANK BAFFLE MADE FROM EXTRUDED POLYPROPELYNE
- BAFFLE FASTENED TO TANK WITH POWER FASTENERS, NYLON NAILIN, MUSHROOM HEAD – ¼" x 1½"

Conditionally APPROVED
DIVISION OF BUILDINGS
SEE CORRESPONDENCE

REV NO.	DATE	REVISION

PREPARED FOR:

LAKE SHORE BURIAL VAULT COMPANY
12780 WEST LISBON RD
BROOKFIELD, WI

PREPARED BY:

DELTA ENGINEERS
184 COURT STREET, BINGHAMTON, NY 13901
TEL: (607) 231-6600 FAX: (607) 231-6650

DATE: 2/18/08	SHEET TITLE: TOP SLAB REINFORCEMENT	DRAWN BY:	KMK
SCALE: N.T.S.		CHKD BY:	RET
PROJECT: 4 BEDROOM RESIDENTIAL E60 ECO POD TANK THREE-COMPARTMENT			
CONTRACTOR:		DWG. NO.	PD-05
DELTA PROJ. NO: 2007.000.018		SHT. NO.	2 OF 5

20130329

~~20080180~~

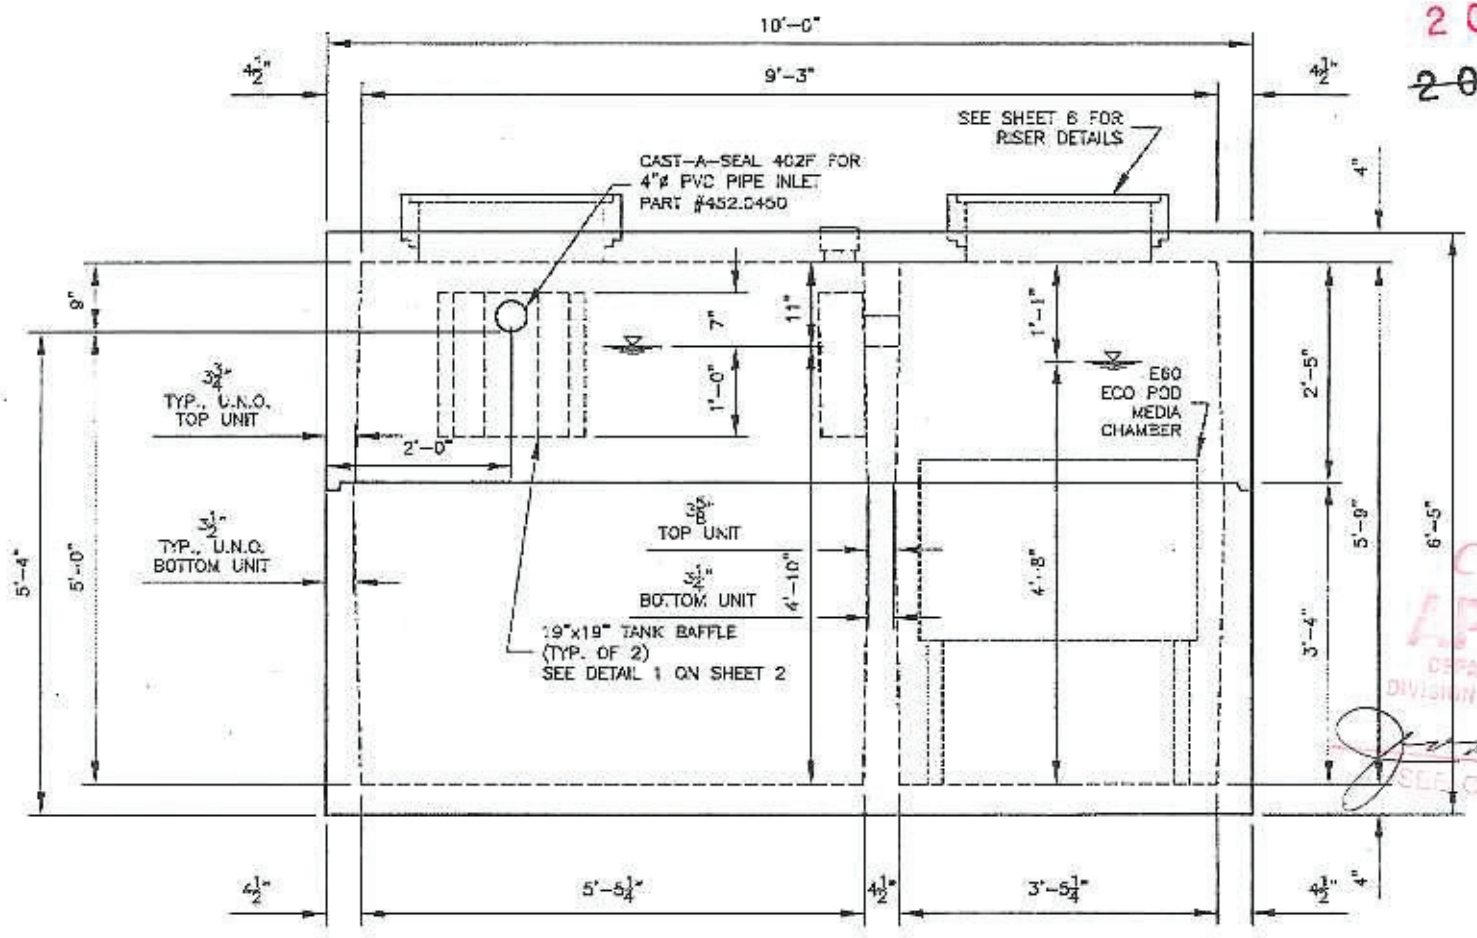

Conditionally APPROVED
DEPARTMENT OF COMMERCE
DIVISION OF BUILDINGS

ELEVATION A-A

PIPE INLET

REV.NO.	DATE	REVISION

PREPARED BY:

DELTA ENGINEERS

184 COURT STREET, BINGHAMTON, NY 13901
TEL: (607) 231-6600 FAX: (607) 231-6650

PREPARED FOR:

LAKE SHORE BURIAL VAULT COMPANY
12780 WEST LISBON RD
BROOKFIELD, WI

DATE: 2/18/08	SHEET TITLE: ELEVATION VIEW	DRWN. BY: KMK	
SCALE: N.T.S.		CKD BY: RET	

PROJECT: 4 BEDROOM RESIDENTIAL E60 ECO POD TANK THREE-COMPARTMENT

CONNECTOR:	DWG. NO.	P0-05
DELTA PROJ. NO. 2007.000.018	SHT. NO.	3 OF 5

20130329

~~20080189~~

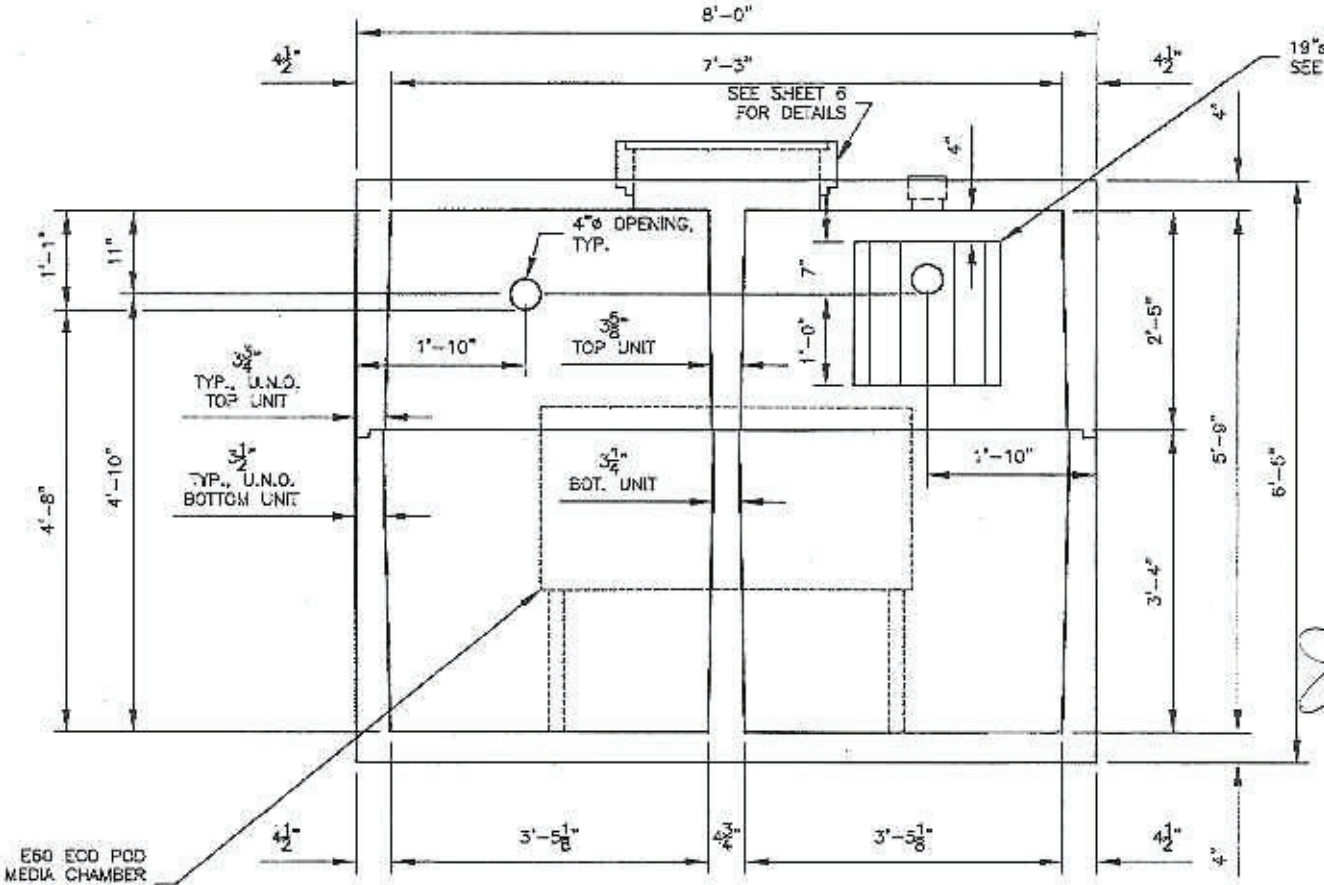

SECTION B–B

Conditionally APPROVED
DEPARTMENT OF COMMERCE
DIVISION OF SAFETY AND BUILDINGS
SEE CORRESPONDENCE

REV.NO.	DATE	REVISION

PREPARED FOR:
LAKE SHORE BURIAL VAULT COMPANY
12780 WEST LISBON RD
BROOKFIELD, WI

PREPARED BY:
DELTA ENGINEERS
184 COURT STREET, BINGHAMTON, NY 13901
TEL: (607) 231-8600 FAX: (607) 231-8650

DATE: 2/18/08
SCALE: N.T.S.
SHEET TITLE: SECTION VIEW
DRWN. BY: KMK
CHD. BY: RET
PROJECT: 4 BEDROOM RESIDENTIAL E60 ECO POD TANK THREE-COMPARTMENT
CONTRACTOR:
DWG. NO.: PD-05
DELTA PROJ. NO.: 2007.000.018
SHT. NO.: 4 OF 8

20130329

~~20080189~~

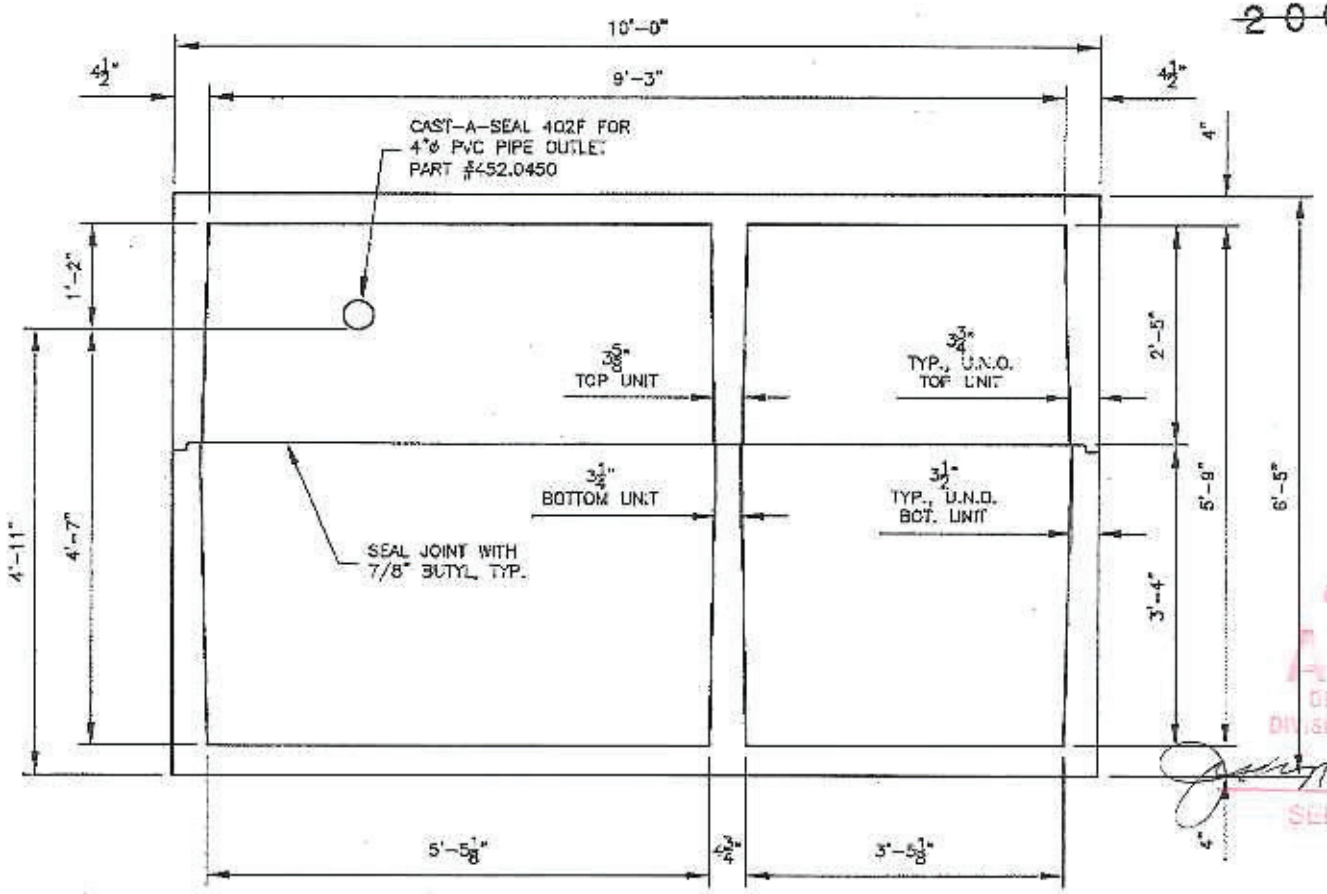

Conditionally APPROVED
DEPARTMENT OF COMMERCE
DIVISION OF SAFETY AND BUILDINGS
SEE CORRESPONDENCE

SECTION C–C
PIPE OUTLET

REV.NO.	DATE	REVISION

PREPARED BY:

DELTA ENGINEERS
184 COURT STREET, BINGHAMTON, NY 13901
TEL: (607) 231-6800 FAX: (607) 231-6850

PREPARED FOR:

LAKE SHORE BURIAL VAULT COMPANY
12780 WEST LISBON RD
BROOKFIELD, WI

DATE: 2/18/08	SHEET TITLE: SECTION VIEW	DRAWN BY:	KMK
SCALE: N.T.S.		CHKD BY:	RET

PROJECT: 4 BEDROOM RESIDENTIAL
E60 ECO POD TANK
THREE-COMPARTMENT

CONTRACTOR:		DWG. NO.	PD-05
DELTA PROJ. NO:	2007.000.018	SHT. NO.	5 OF 6

20130329

~~20080189~~

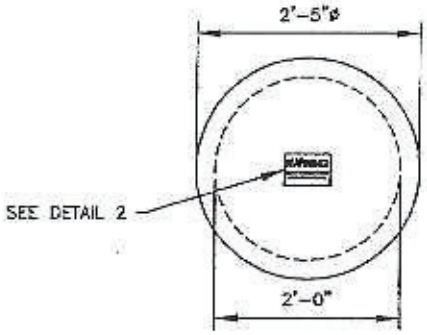

PLAN VIEW
MANHOLE COVER

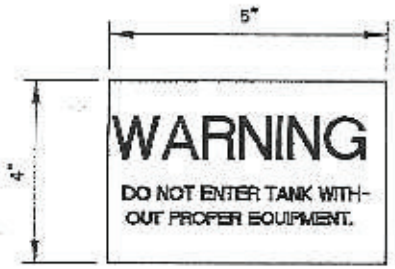

DETAIL 2
(PLAN VIEW)
WARNING PLAQUE ON MANHOLE COVER, TYP.

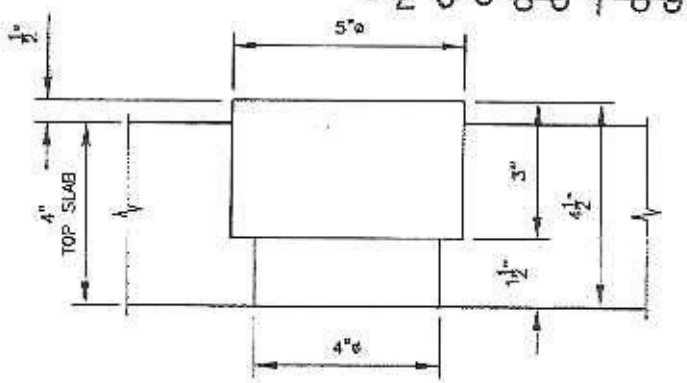

DETAIL 3
BOSS STOP FOR 4"ø PIPE
(SECTION VIEW)

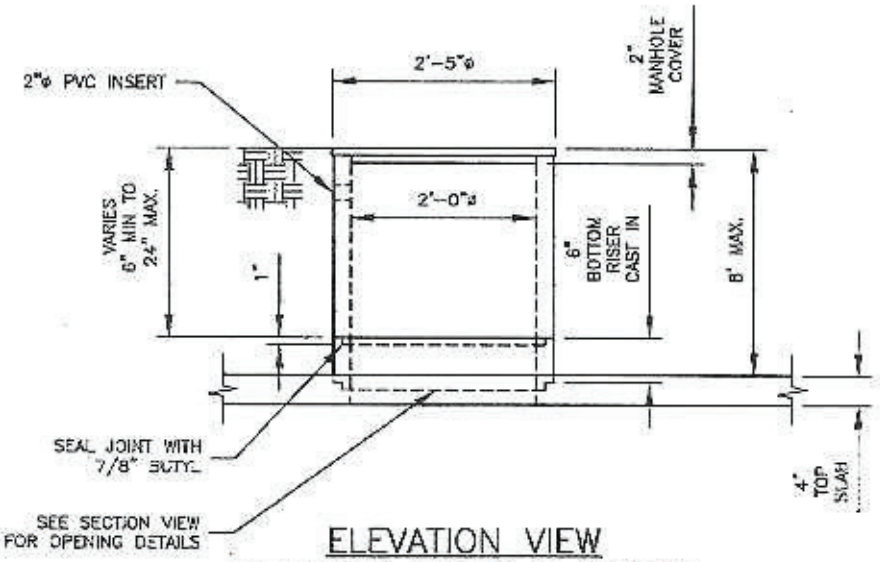

ELEVATION VIEW
MANHOLE RISER W/COVER

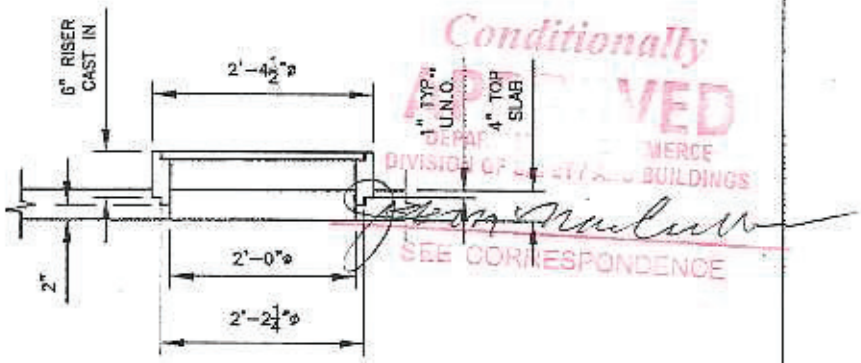

SECTION VIEW
OPENING DETAIL TOP SLAB, TYP.

Conditionally APPROVED
DEPARTMENT OF COMMERCE
DIVISION OF ... BUILDINGS
SEE CORRESPONDENCE

REV.NO.	DATE	REVISION

PREPARED FOR:
LAKE SHORE BURIAL VAULT COMPANY
12780 WEST LISBON RD
BROOKFIELD, WI

PREPARED BY:
DELTA ENGINEERS
184 COURT STREET, BINGHAMTON, NY 13901
TEL: (607) 231-8800 FAX: (607) 231-8850

DATE: 2/18/08	SHEET TITLE: DETAILS	Drawn By:	KMK
SCALE: N.T.S.		Chkd By:	RET

PROJECT: 4 BEDROOM RESIDENTIAL
E60 ECO POD TANK
THREE-COMPARTMENT

CONTRACTOR:	DWG. NO.	PD-05
DELTA PROJ. NO.: 2007.000.018	SHT. NO.	6 OF 6