MARK	EQUIPMENT LISTING AND SUPPLIER	CSI	CUSTOMER	MARK	EQUIPMENT LISTING AND SUPPLIER	CSI	CUSTOMER
A	C.S.I. SINGLE WALL FIBERGLASS TANK	X		E	24" PVC RISER WITH COVER	X	
B	C.S.I. FRP HOLD DOWN STRAP & TURNBUCKLE ASSEMBLY	X		F	4" NPT FITTING WITH DEFLECTER PLATE - VENT		X
C	C.S.I. PRECAST DEADMAN ANCHOR WITH EYEBOLTS	X		G	4" PVC INLET PIPING WITH SANITARY TEE	X	
D	23.5" FIBERGLASS COLLAR WITH TANK ACCESS OPENING	X		H	4" PVC OUTLET PIPING WITH SANITARY TEE	X	

20140158


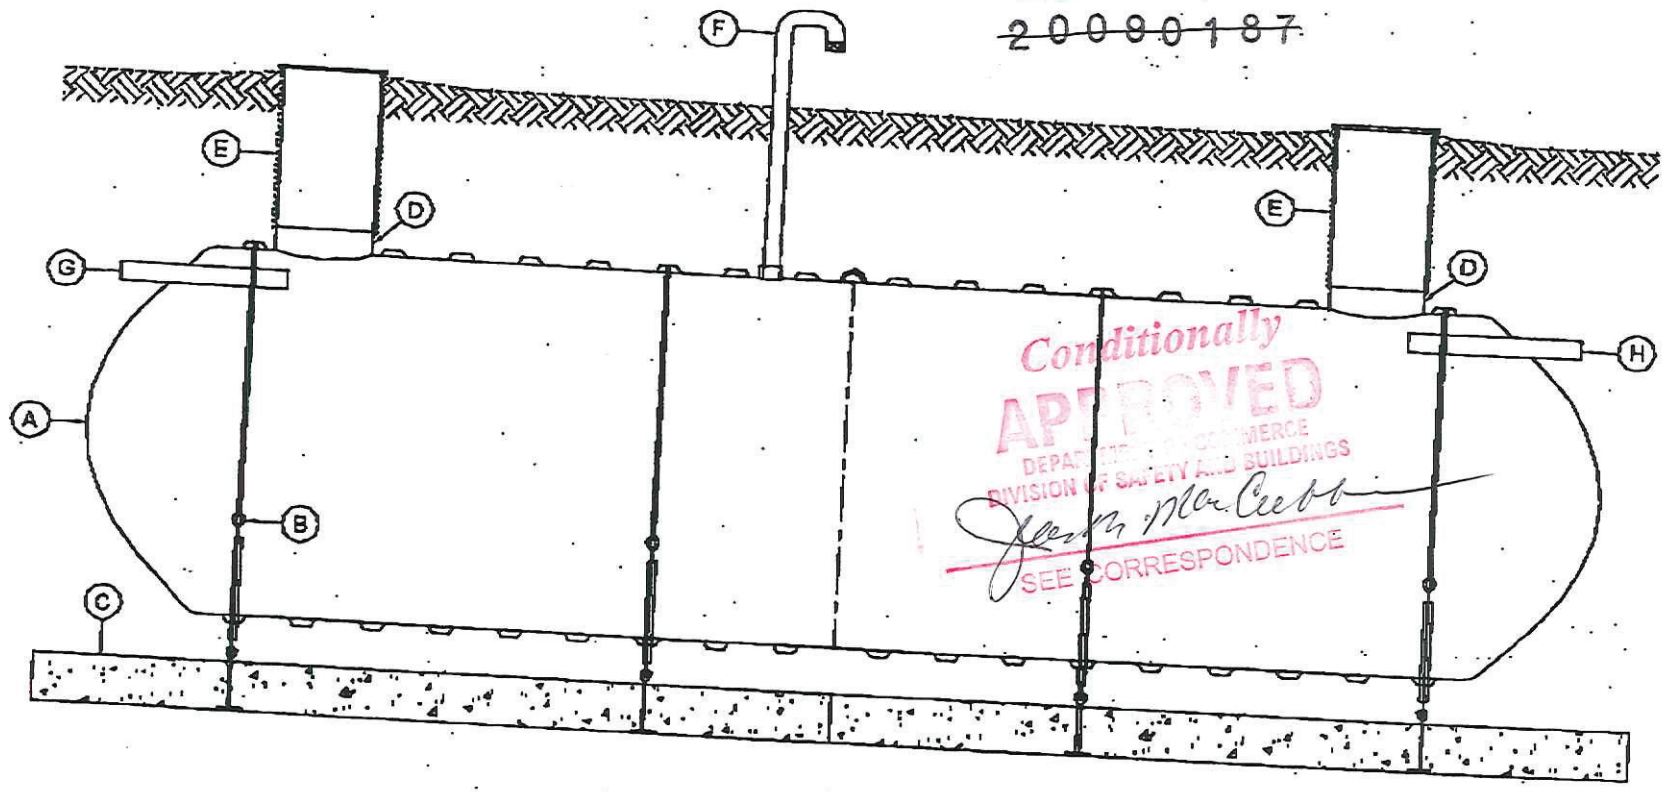

Conditionally APPROVED
DEPARTMENT OF COMMERCE
DIVISION OF SAFETY AND BUILDINGS
SEE CORRESPONDENCE

THIS DRAWING AND DESIGN SHOWN HEREIN IS THE PROPERTY OF CONTAINMENT SOLUTIONS INC. USE OR COPIES CANNOT BE MADE WITHOUT THE CONSENT OF CONTAINMENT SOLUTIONS INC.

TYPICAL ILLUSTRATION DRAWING

SEPTIC STORAGE TANK

CONTAINMENT SOLUTIONS

WATER-HOLDING 8/12/02 KA.SOEDER/RBS

SHELL CODES: 1-E8S06SD, 1-E8SECSD

20140158

~~20090187~~

Conditionally APPROVED
DEPARTMENT OF COMMERCE
DIVISION OF SAFETY AND BUILDINGS
SEE CORRESPONDENCE

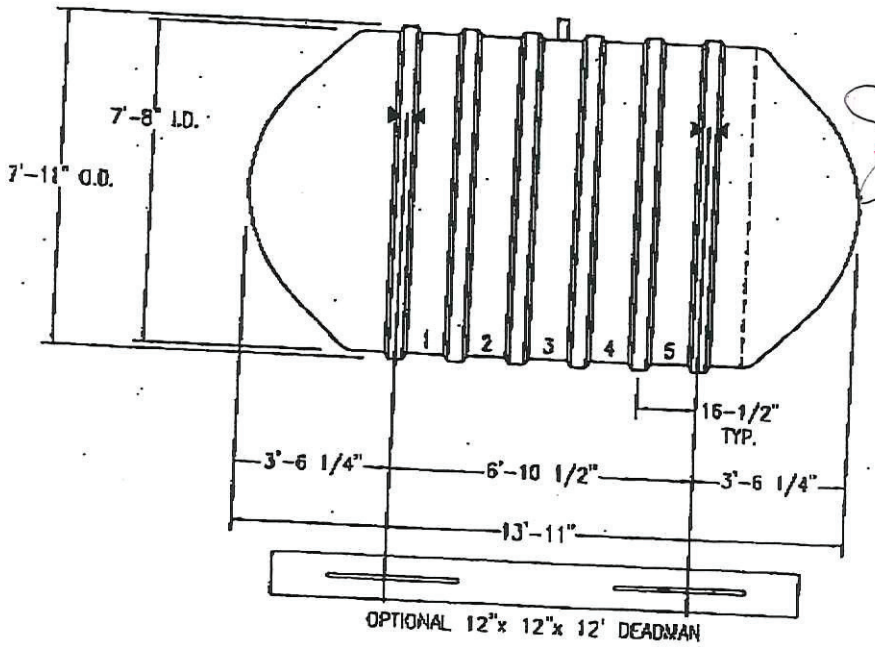

NOTES:

- ⊠ HOLD DOWN STRAP CLIP
- ▶◀ HOLD DOWN STRAP LOCATION
- ▯ TYPE "13" LIFT LUG - SD
- ▮ TYPE "13" LIFT LUG - HD

SWT G-6 (8')-4000		DATE: 8/1/2003
		DRAWN BY: K.A.SOEDER
CONTAINMENT SOLUTIONS	CAPACITY: 3,998	REVISED:
	WEIGHT: DRY/WET 1550	DWG NUMBER: 84SWG6