20160193 A

~~20130342 A~~

REVISION HISTORY				
ZONE	REV	DESCRIPTION	DATE	APPROVED

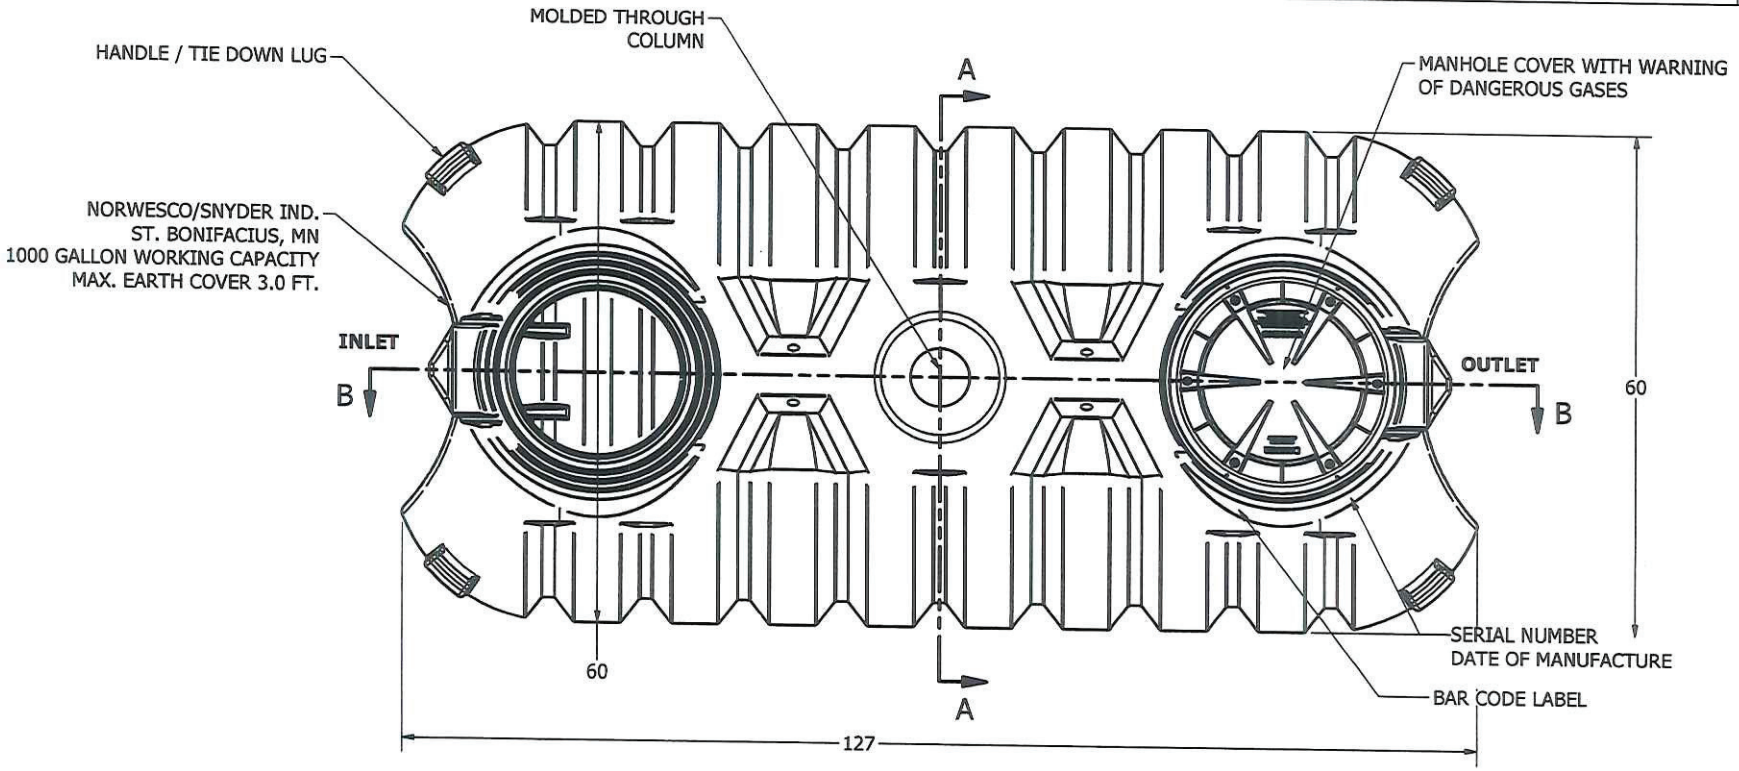

Conditionally
APPROVED

SEE CORRESPONDENCE

DRAWN	Todd Bolzer	5/27/2011
CHECKED		
QA		
MFG		
APPROVED		

NORWESCO
NORWESCO, INC., ST. BONIFACIUS, MN

TITLE
1000 GALLON LOW PROFILE HOLDING AND PUMP TANK WISCONSIN

SIZE	REV
B	

SCALE: 1/16

SHEET 1 OF 2

RECEIVED
OCT 21 2013
SAFETY & BUILDINGS

Conditionally APPROVED

20160193A

~~20130342A~~

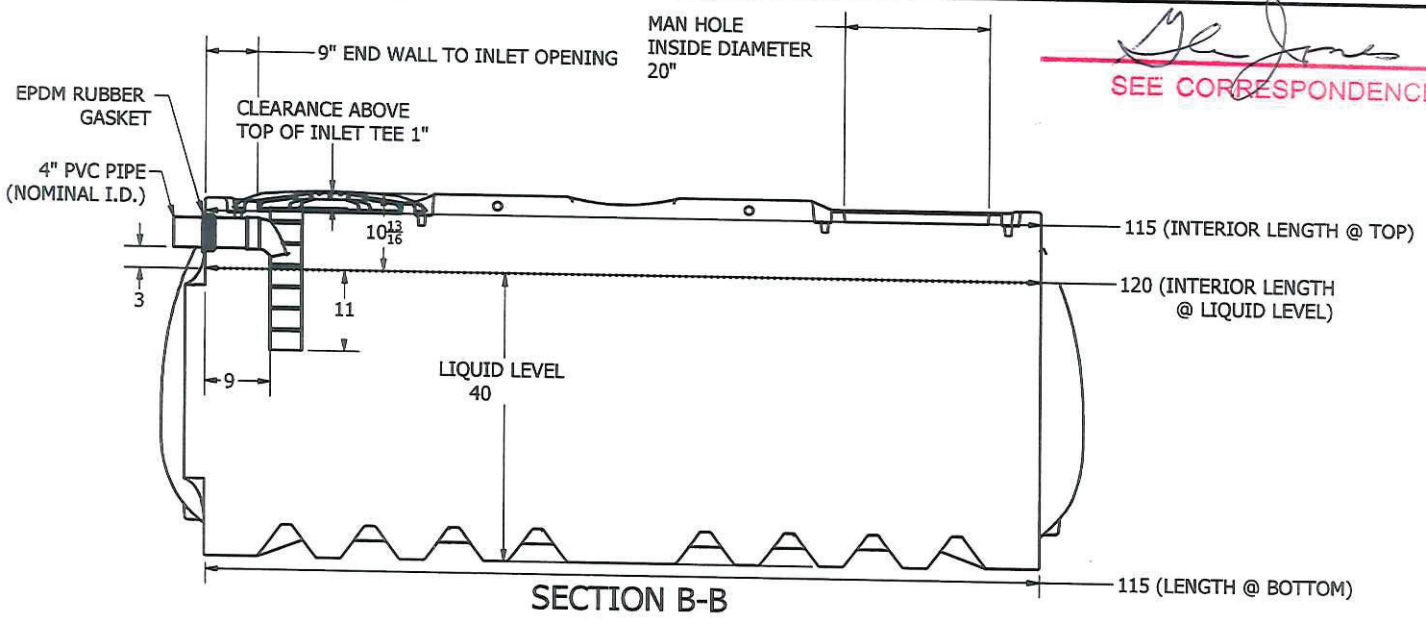

SEE CORRESPONDENCE

SECTION B-B

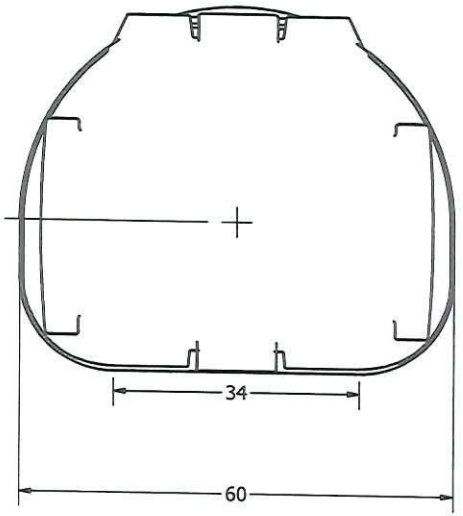

SECTION A-A
SCALE 0.06 : 1

TANK SPECIFICATIONS	
INTERIOR LENGTH @ TOP	115 IN
INTERIOR LENGTH @ LIQUID LEVEL	120 IN
INTERIOR LENGTH @ BOTTOM	115 IN
INTERIOR WIDTH @ TOP	0 IN
INTERIOR WIDTH @ LIQUID LEVEL	50 IN
INTERIOR WIDTH @ BOTTOM	40 IN
HEIGHT (INTERIOR)	50.5 IN
LIQUID LEVEL	40 IN
WORKING CAPACITY	1004 GALLONS
FREEBOARD	15%
TANK TOP THICKNESS	.25 IN
TANK SIDE THICKNESS	.25 IN
TANK BOTTOM THICKNESS	.25 IN
TANK END THICKNESS	.25 IN

DRAWN	Todd Bolzer	5/27/2011
CHECKED		
QA		
MFG		
APPROVED		

NORWESCO
NORWESCO, INC., ST. BONIFACIUS, MN

TITLE

1000 GALLON LOW PROFILE HOLDING AND PUMP TANK WISCONSIN

SIZE		REV
B		

SCALE: 1/16 SHEET 2 OF 2

RECEIVED
OCT 21 2013
SAFETY & BUILDINGS

20160193 A

~~20130342 A~~

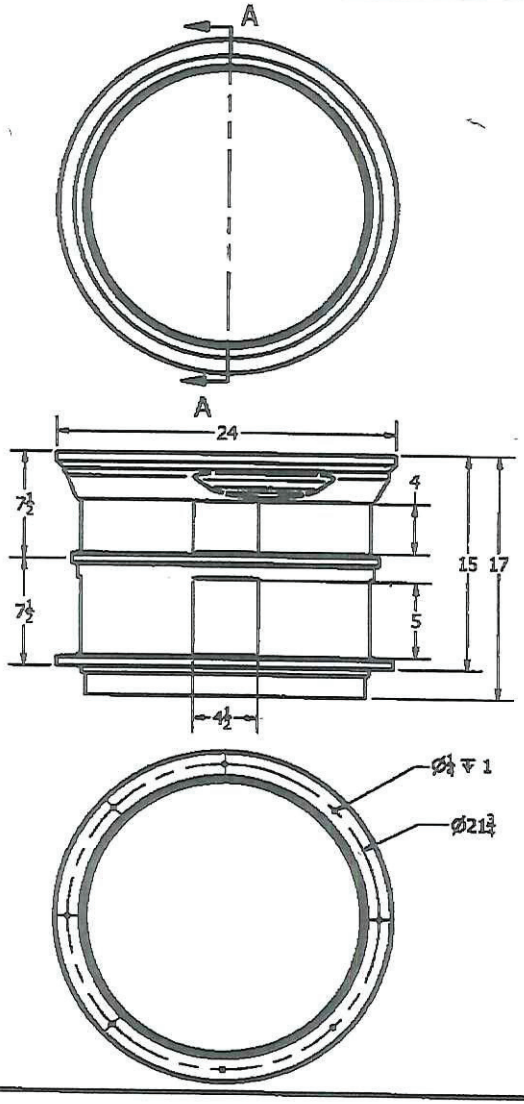

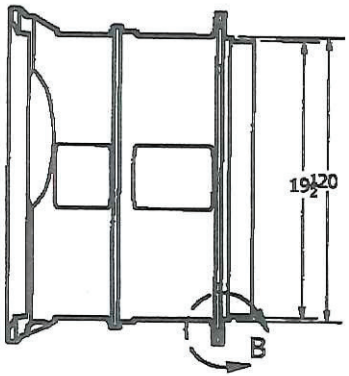

SECTION A-A
SCALE 1 /8

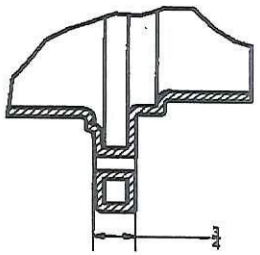

DETAIL B
SCALE 1 / 2

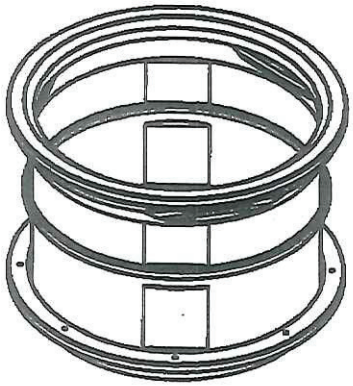

DRAWN Todd Bolzer	5/10/2009	NORWESCO, INC., ST. BONIFACIUS, MN
CHECKED		TITLE: 15 INCH LOW PROFILE MAN HOLE EXTENSION
QA		
MFG		
APPROVED		SIZE: B; DWG NO; REV: E
		SCALE: 1/16; SHEET 1 OF 1

RECEIVED
OCT 21 2013
SAFETY & BUILDINGS